
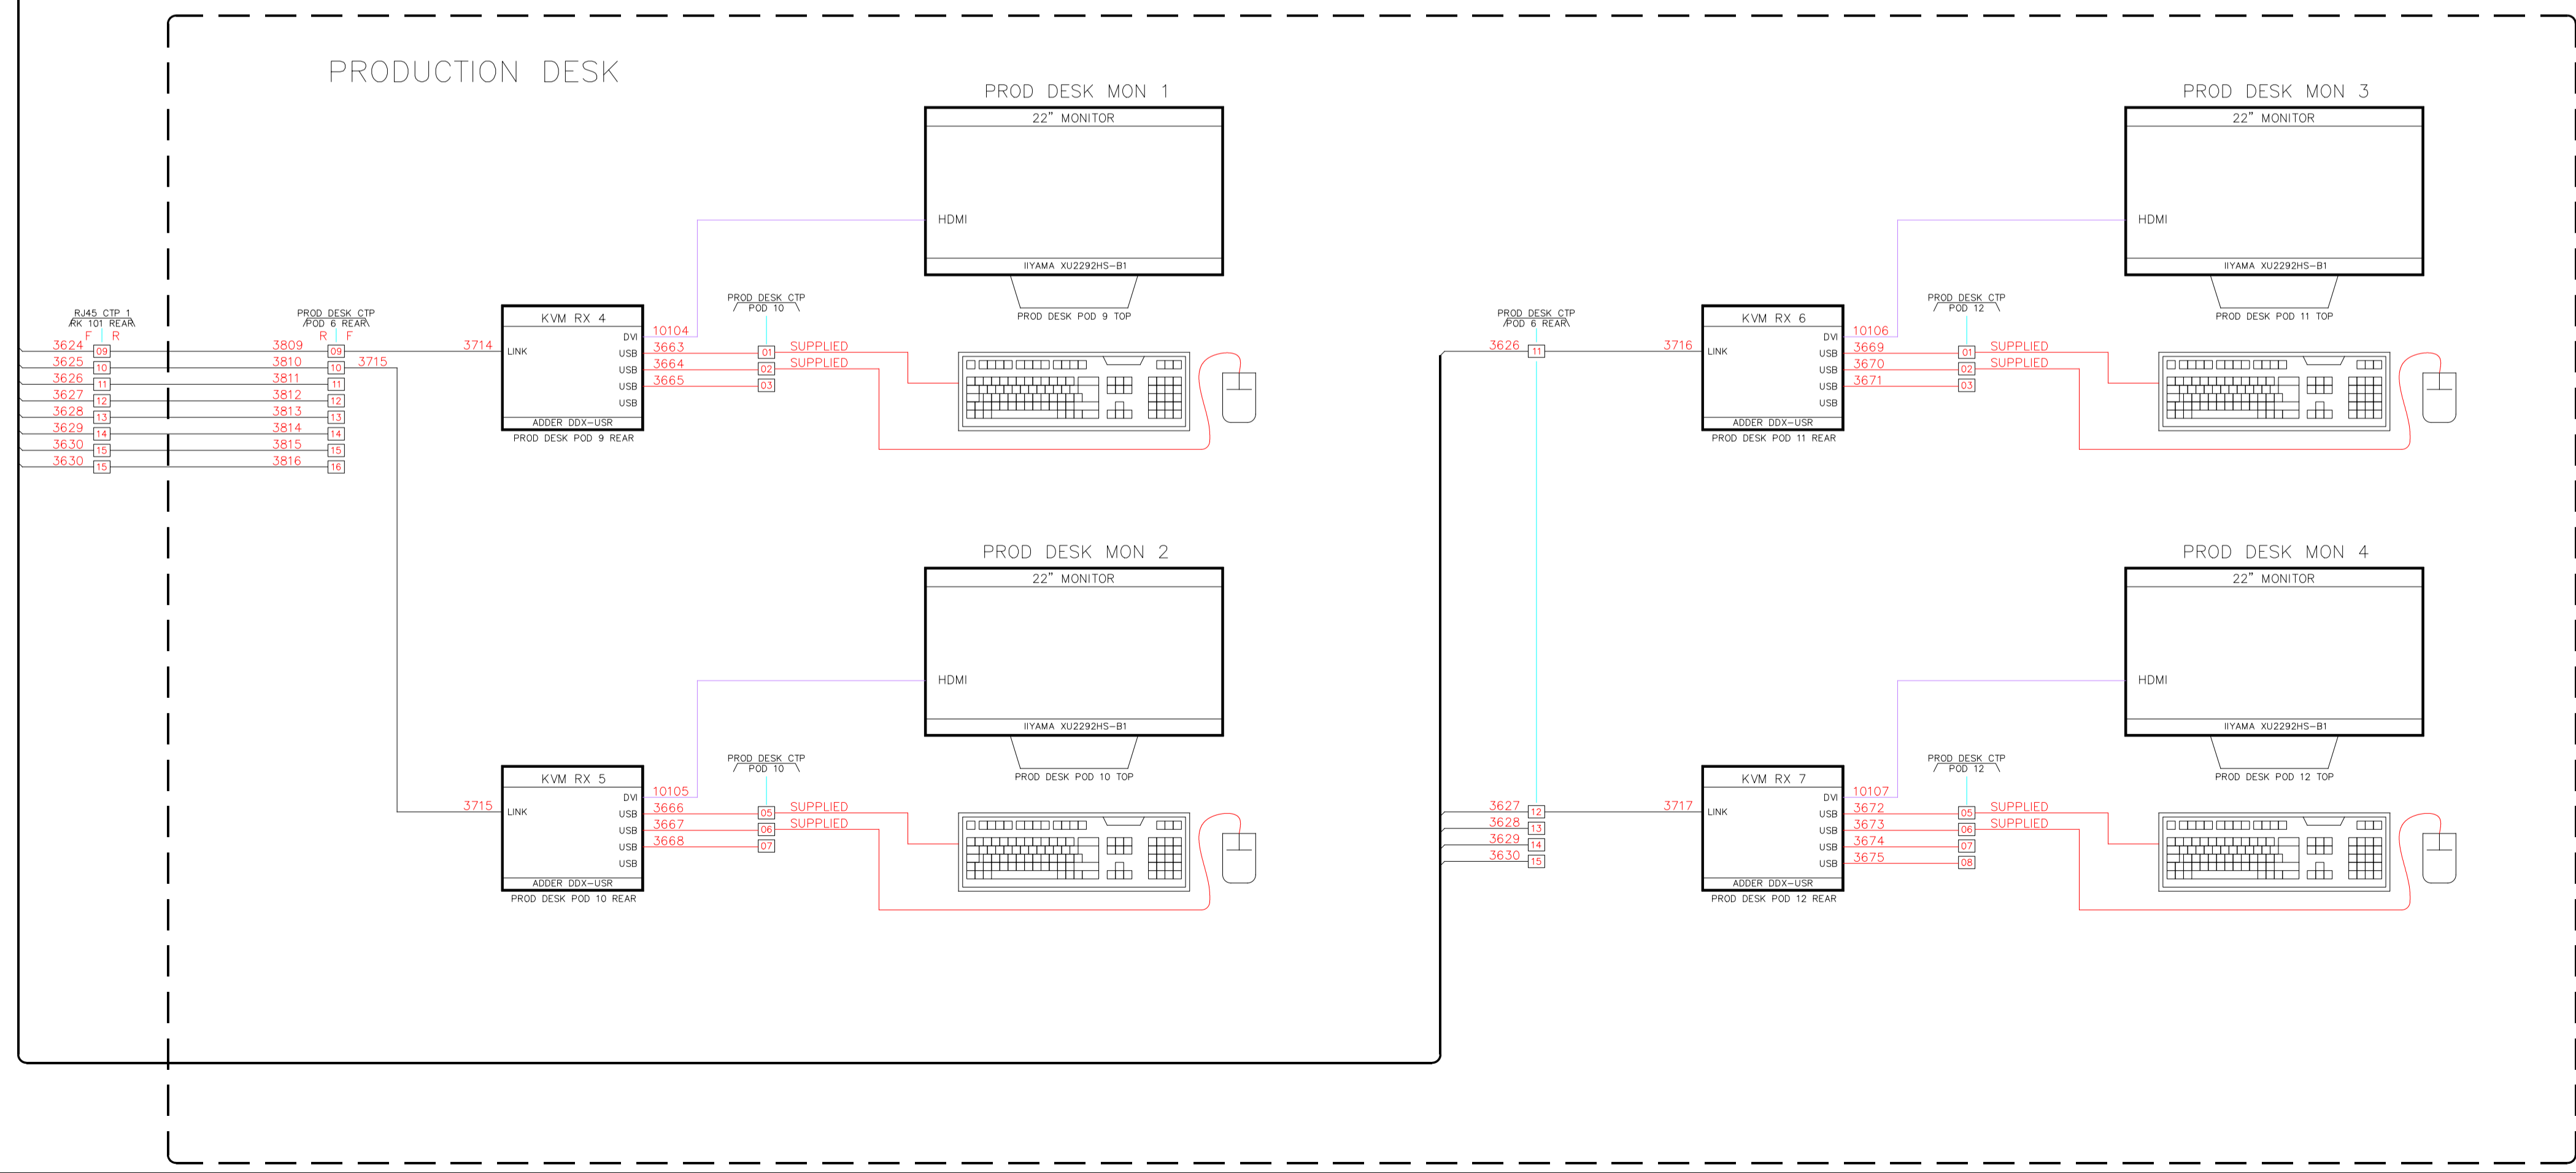


Zone Ref	Description	Revised By	Date	Approval
ALL A	EXTRACTED FROM CUSTOMER ISSUED FOR CLIENT APPROVAL.	MPS	27/06/19	
ALL B	MINOR UPDATES ISSUED FOR CLIENT APPROVAL.	MPS	28/07/19	
ALL C	AS BUILT.	MPS	14/10/19	

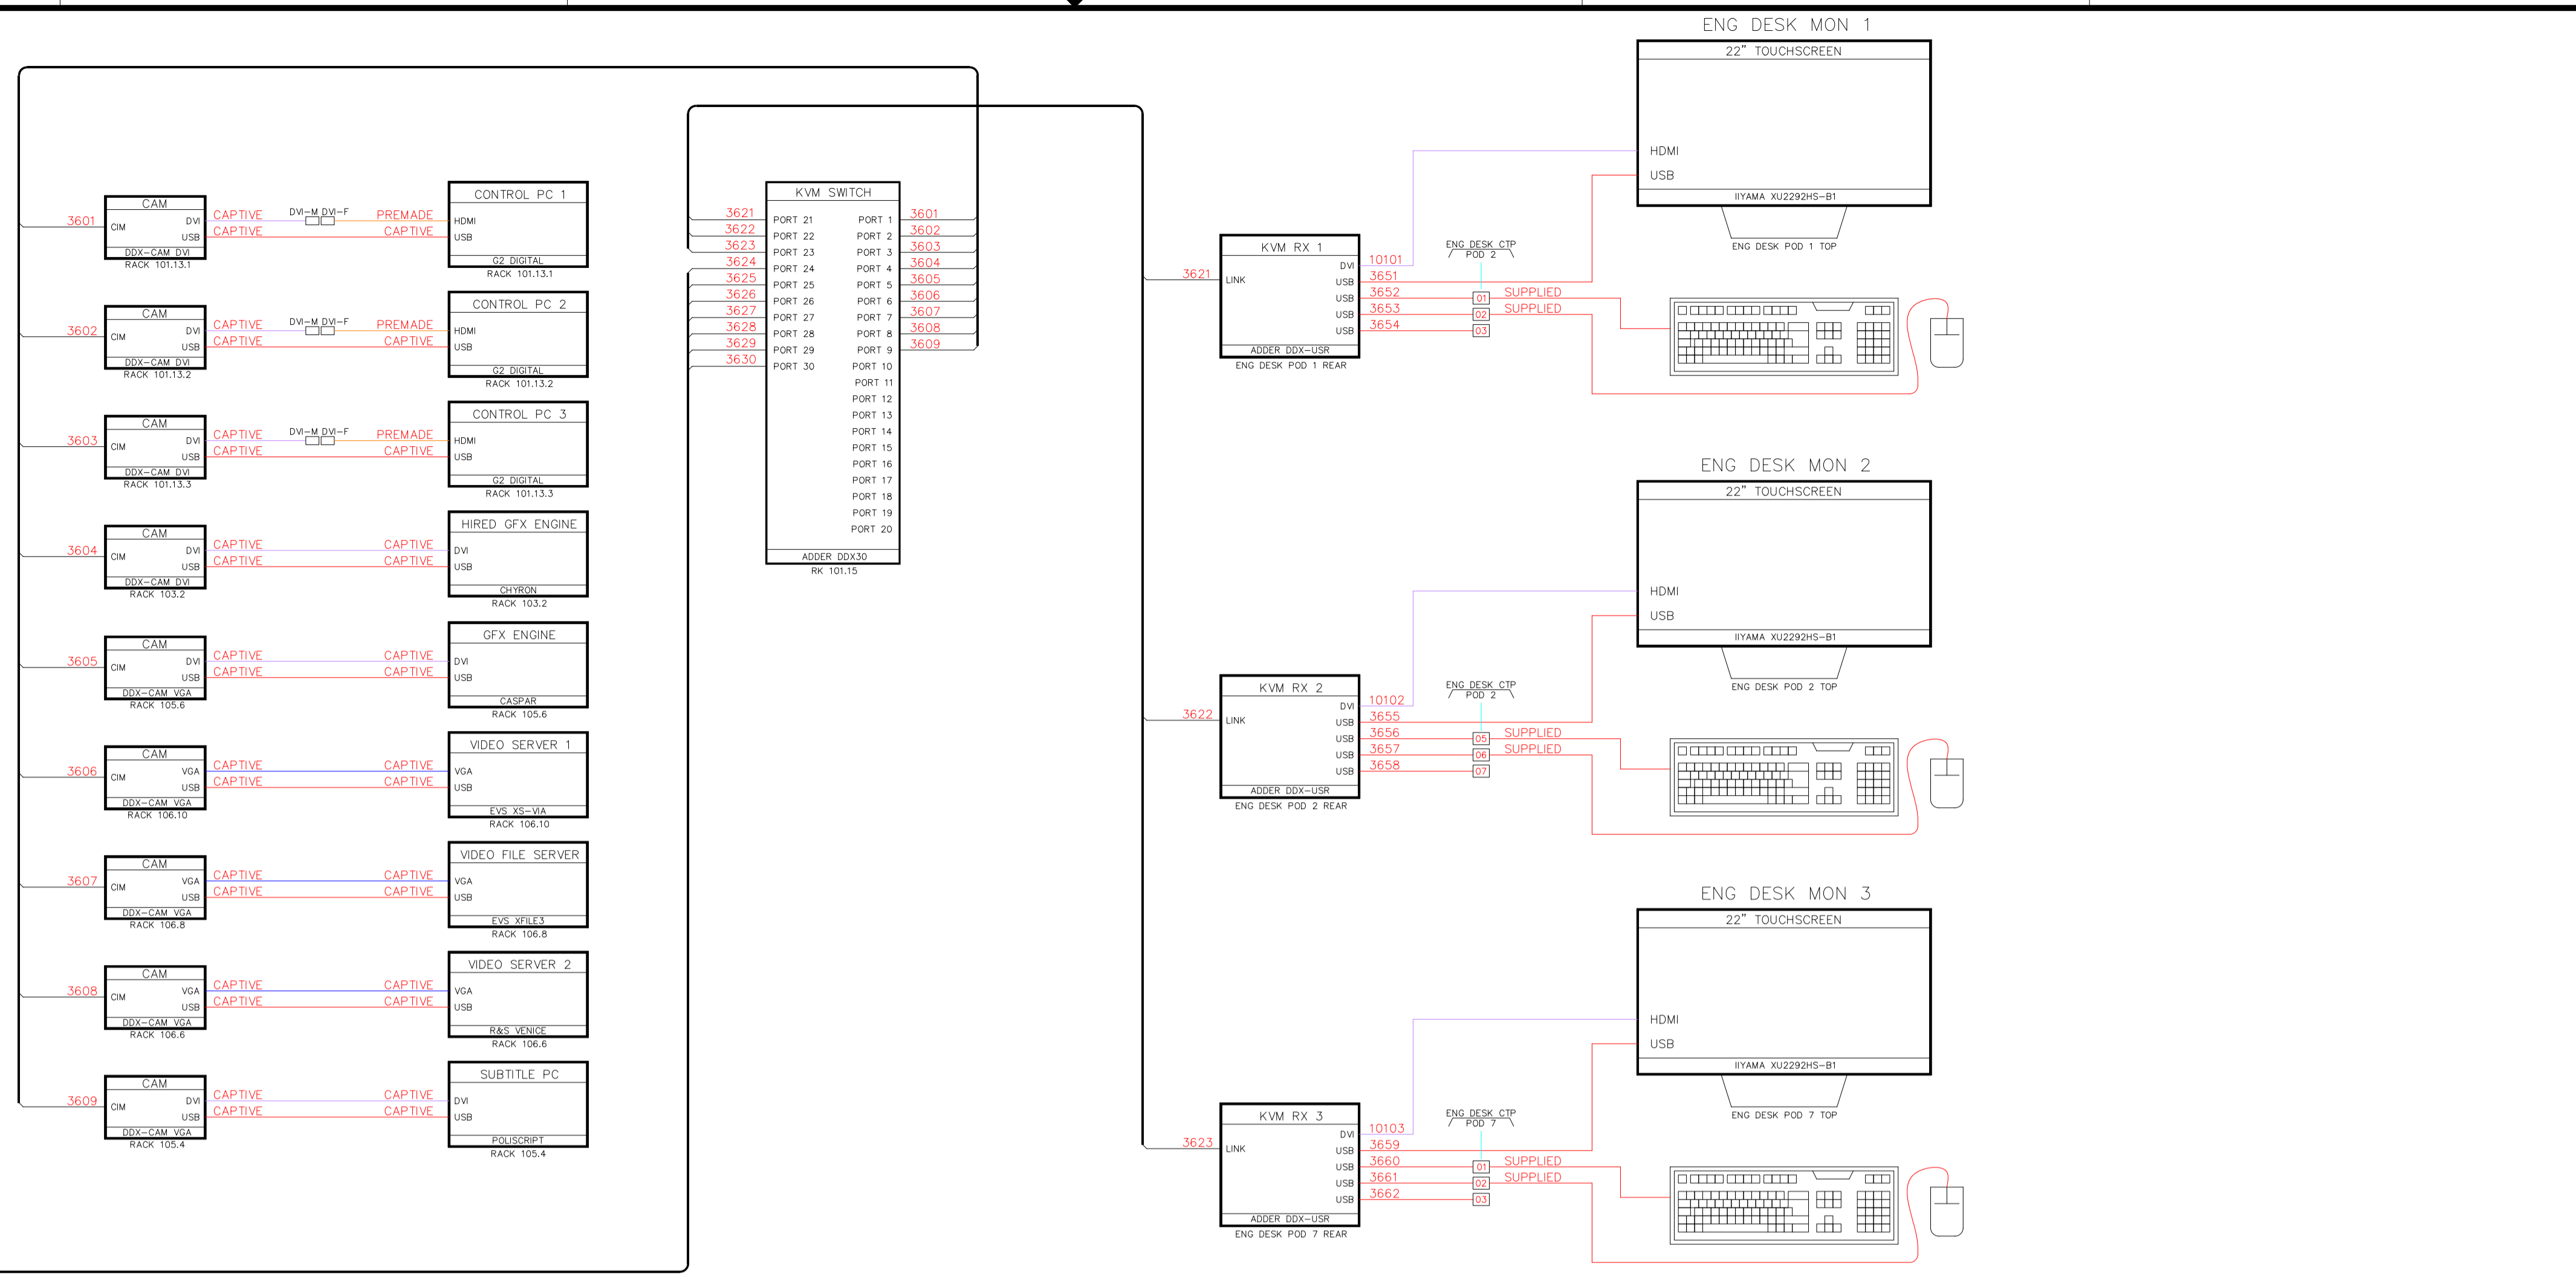

MHZ

UNIT 39 LANCASTER WAY
BUSINESS PARK
WITCHFORD, ELY
CAMBRIDGESHIRE
CB6 3NW
UNITED KINGDOM
(TEL) +44 (0)1353 645000
(FAX) +44 (0)1353 658919
www.megahertz.co.uk

© 2019 MEGHERTZ LIMITED
The contents of this document are confidential and are not to be disclosed to a third party without the prior written permission of MEGHERTZ LTD.



Proj. Mgr.:	KVN	Proj. Start Date:	19/05/19
Designer:	MPS	Last Plot:	
Approved:		Approval Date:	
Drawn:	MPS	Issue Date:	
Scale:	N.T.S.	Last Rev. by:	14/10/19 MPS
The Ref.:	E4537R03	No. of sheets:	1 of 1

ROYAL OPERA HOUSE
ROH
MEDIA SUITE
KVM SCHEMATIC

REV. No. 4537 E4537R03