

7

6

5

4

3

2

1

D

D

C


C

B

B

A

A

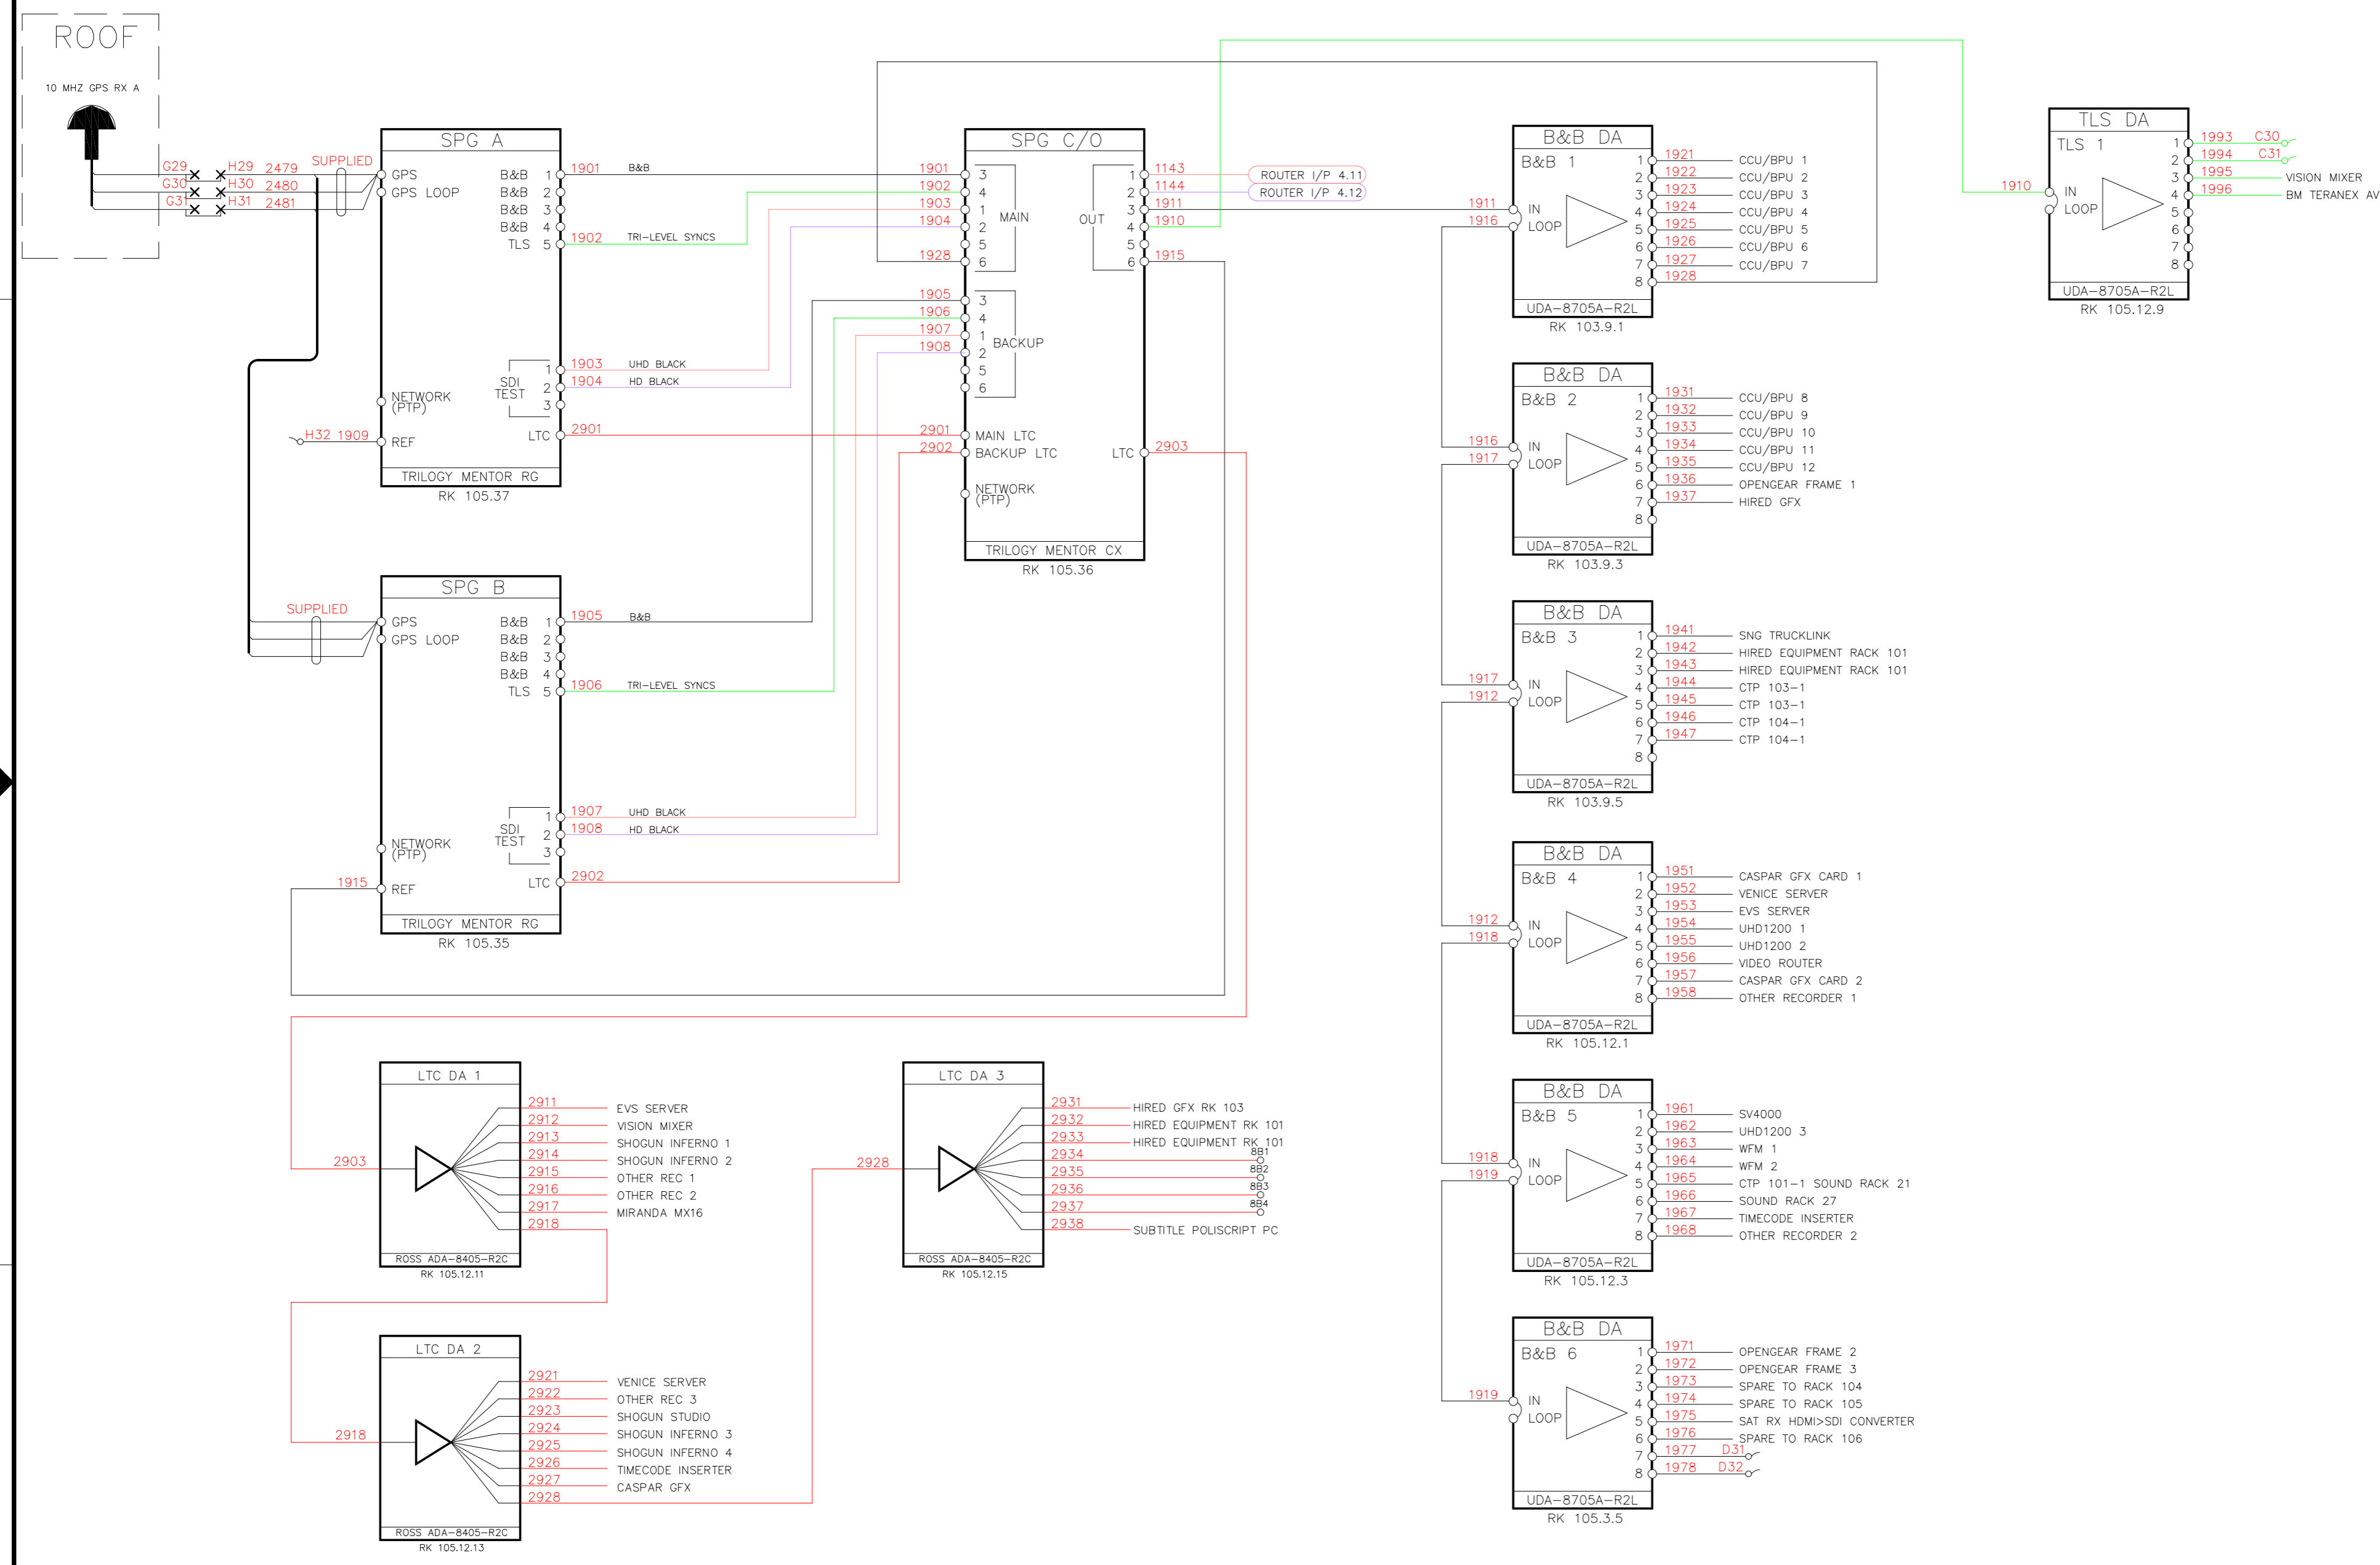

Zone	Rev	Description	Revised By	Date	Approval
ALL	A	FIRST ISSUE	MFR	02/07/19	
ALL	B	UPDATED SPG OUTPUT CONFIGURATION	MFR	28/08/19	
ALL	C	AS BUILT	MFR	14/10/19	

**MHZ**

UNIT 39 LANCASTER WAY  
BUSINESS PARK  
WITCHER CROFT, ELY  
CAMBRIDGESHIRE  
CB6 3NW  
UNITED KINGDOM  
(TEL) +44 (0)1353 645000  
(FAX) +44 (0)1353 658919

www.megahertz.co.uk

© 2019 MEGHERTZ LIMITED  
The contents of this document are confidential and are not to be disclosed to a third party without the prior written permission of MEGHERTZ LTD

Project Address:

**ROYAL OPERA HOUSE**  
COVENT GARDEN

Proj. Mgr. : KN	Proj. Start Date : 22/05/19
Designer : MFR	Last Plot :
Approved :	Approval Date :
Drawn : MFR	Issue Date :
Scale : N.T.S.	Last Rev. by : 14/10/19 MFR
File Ref. : ES/NEE/00/00/00/00/00/00	No. of sheets : 1 of 1

ROYAL OPERA HOUSE

ROH  
MEDIA SUITE  
REFERENCE SCHEMATIC

CD	Proj. No.	Rev. No.	REV
A2	4537	E4537V03	C

7

6

5

4

3

2

1