

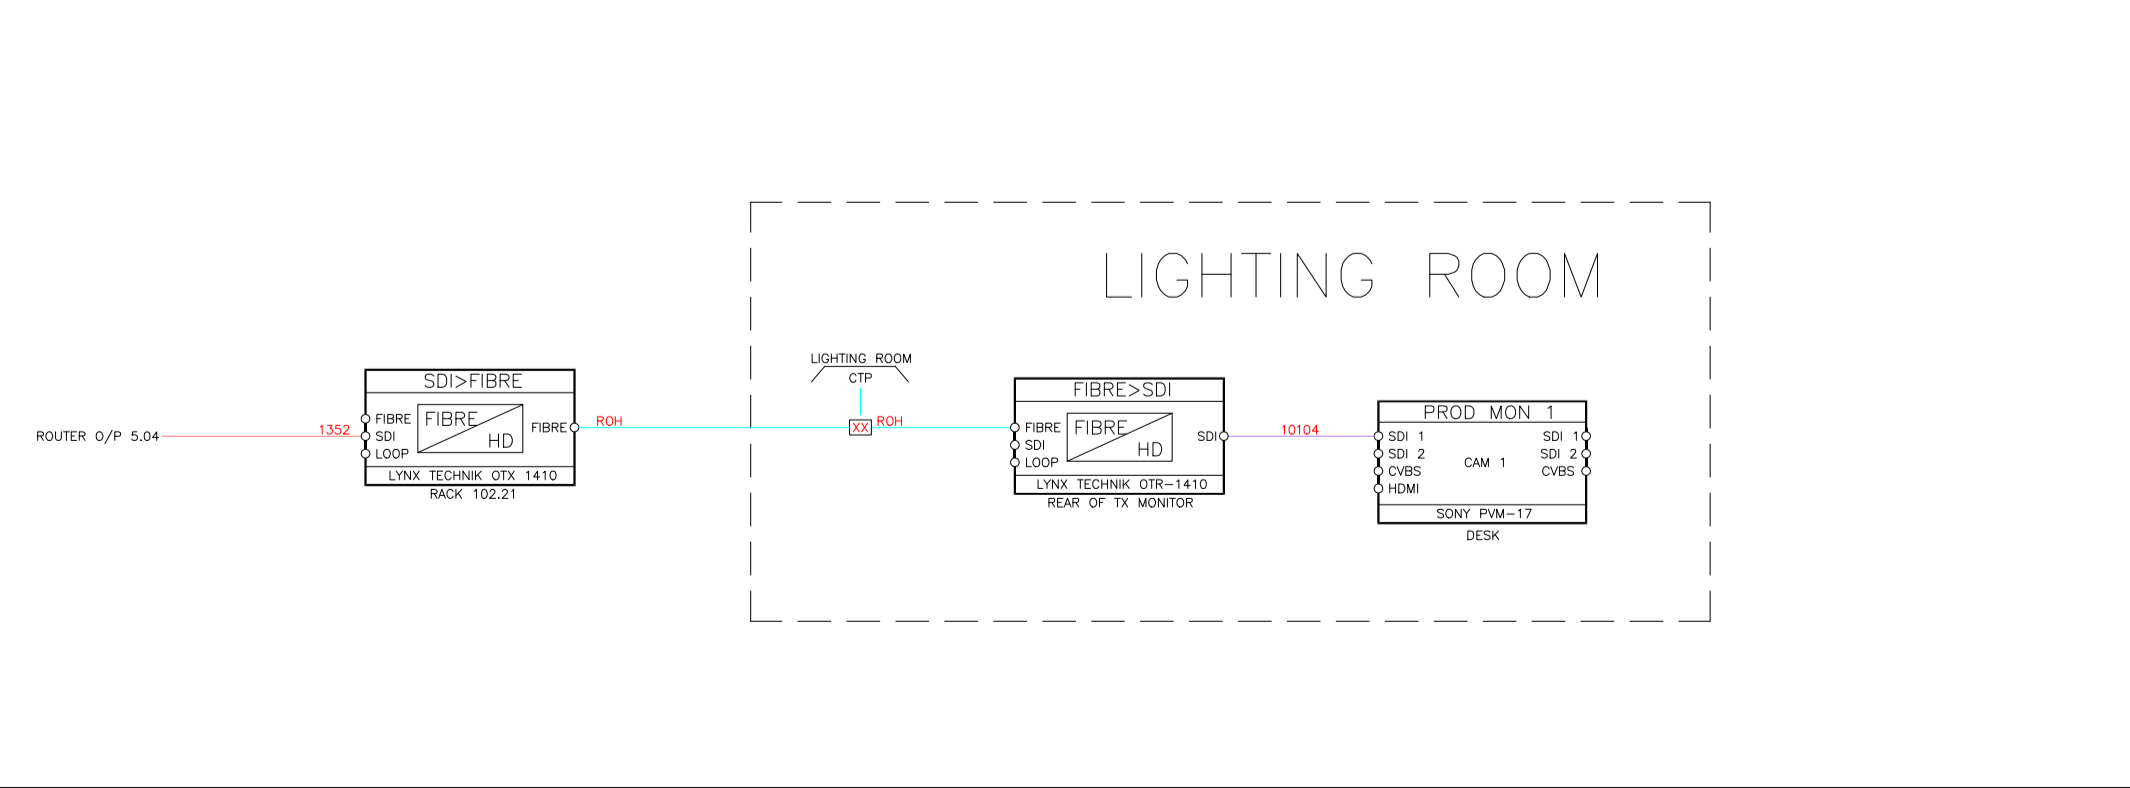
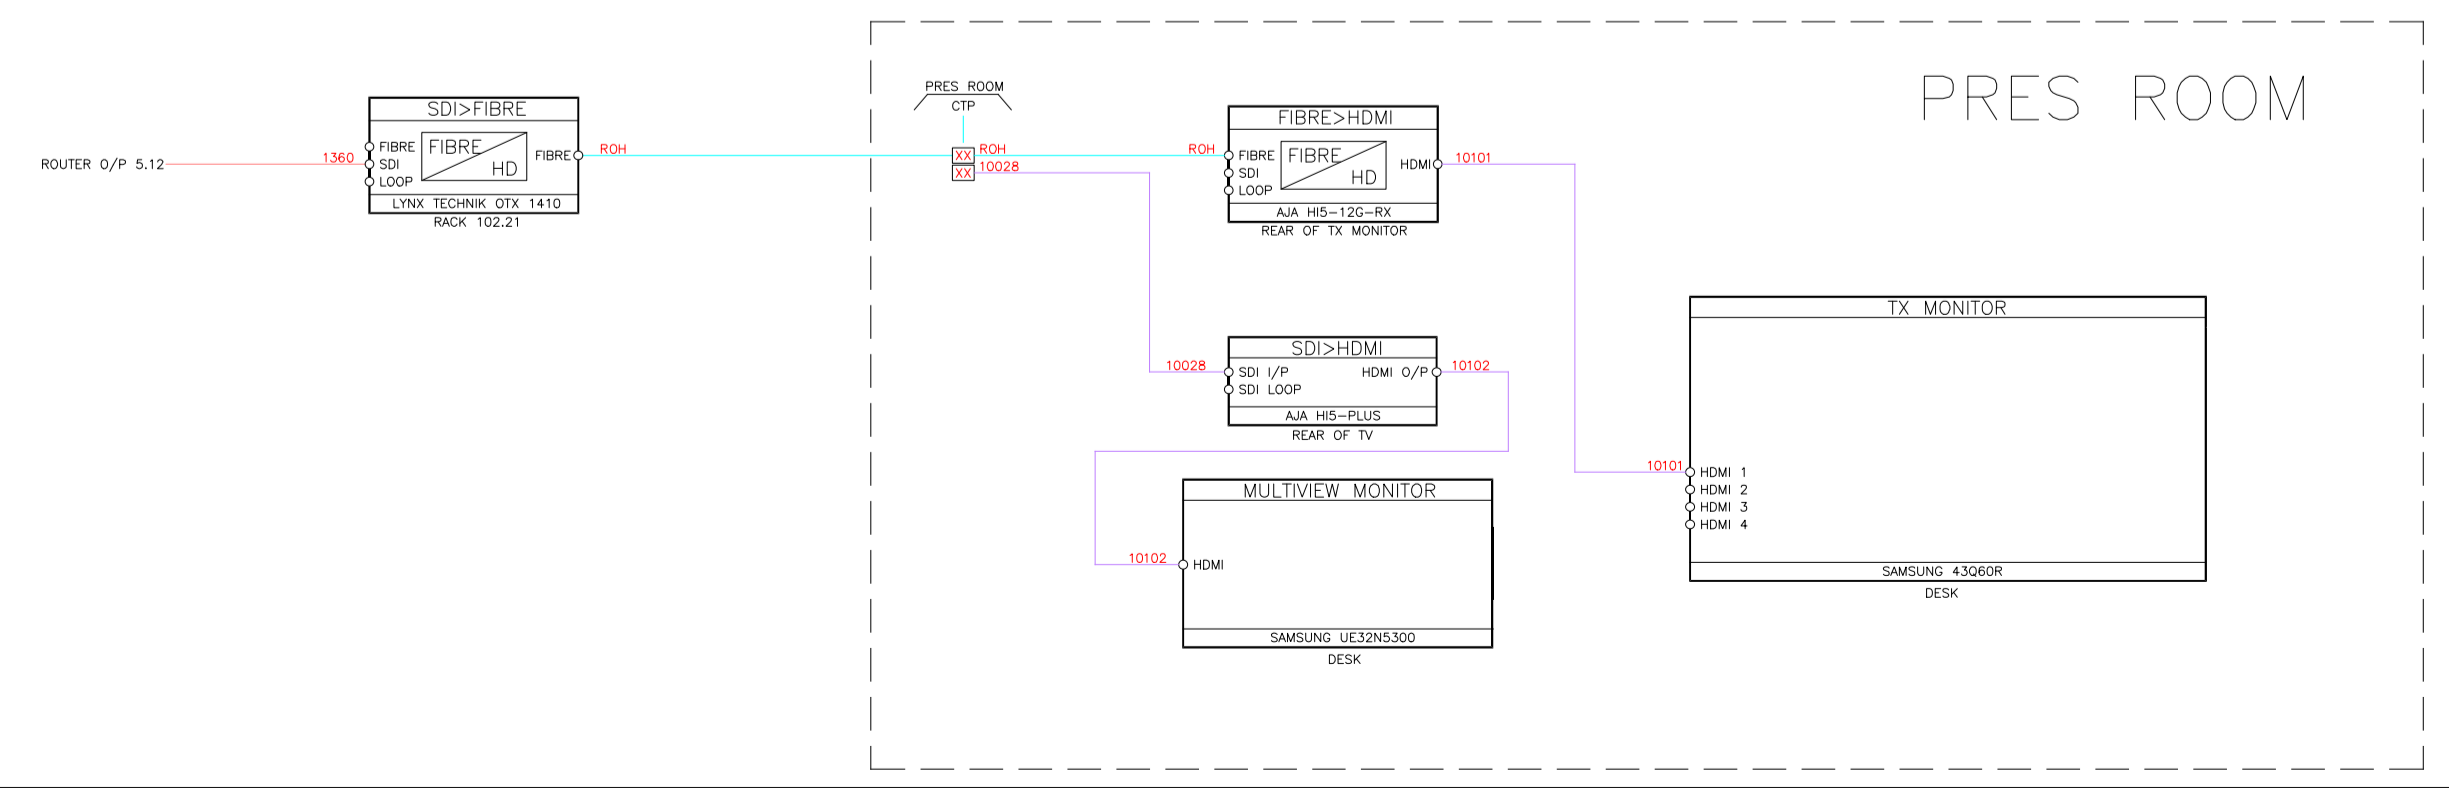
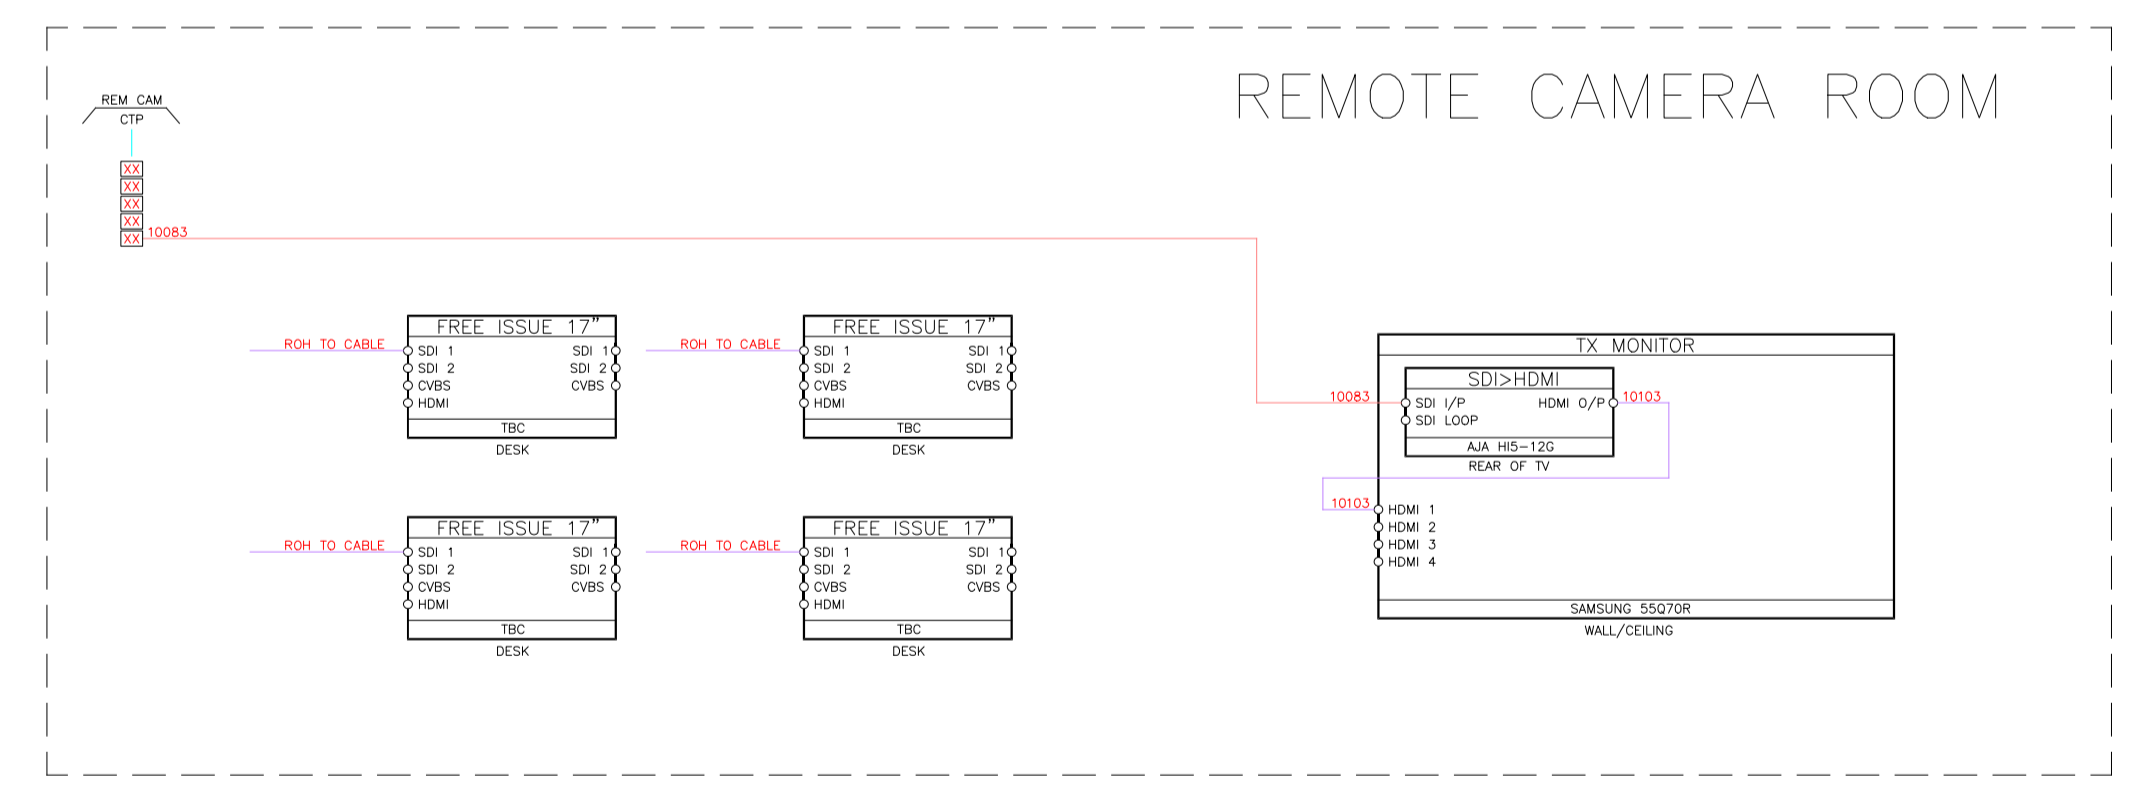
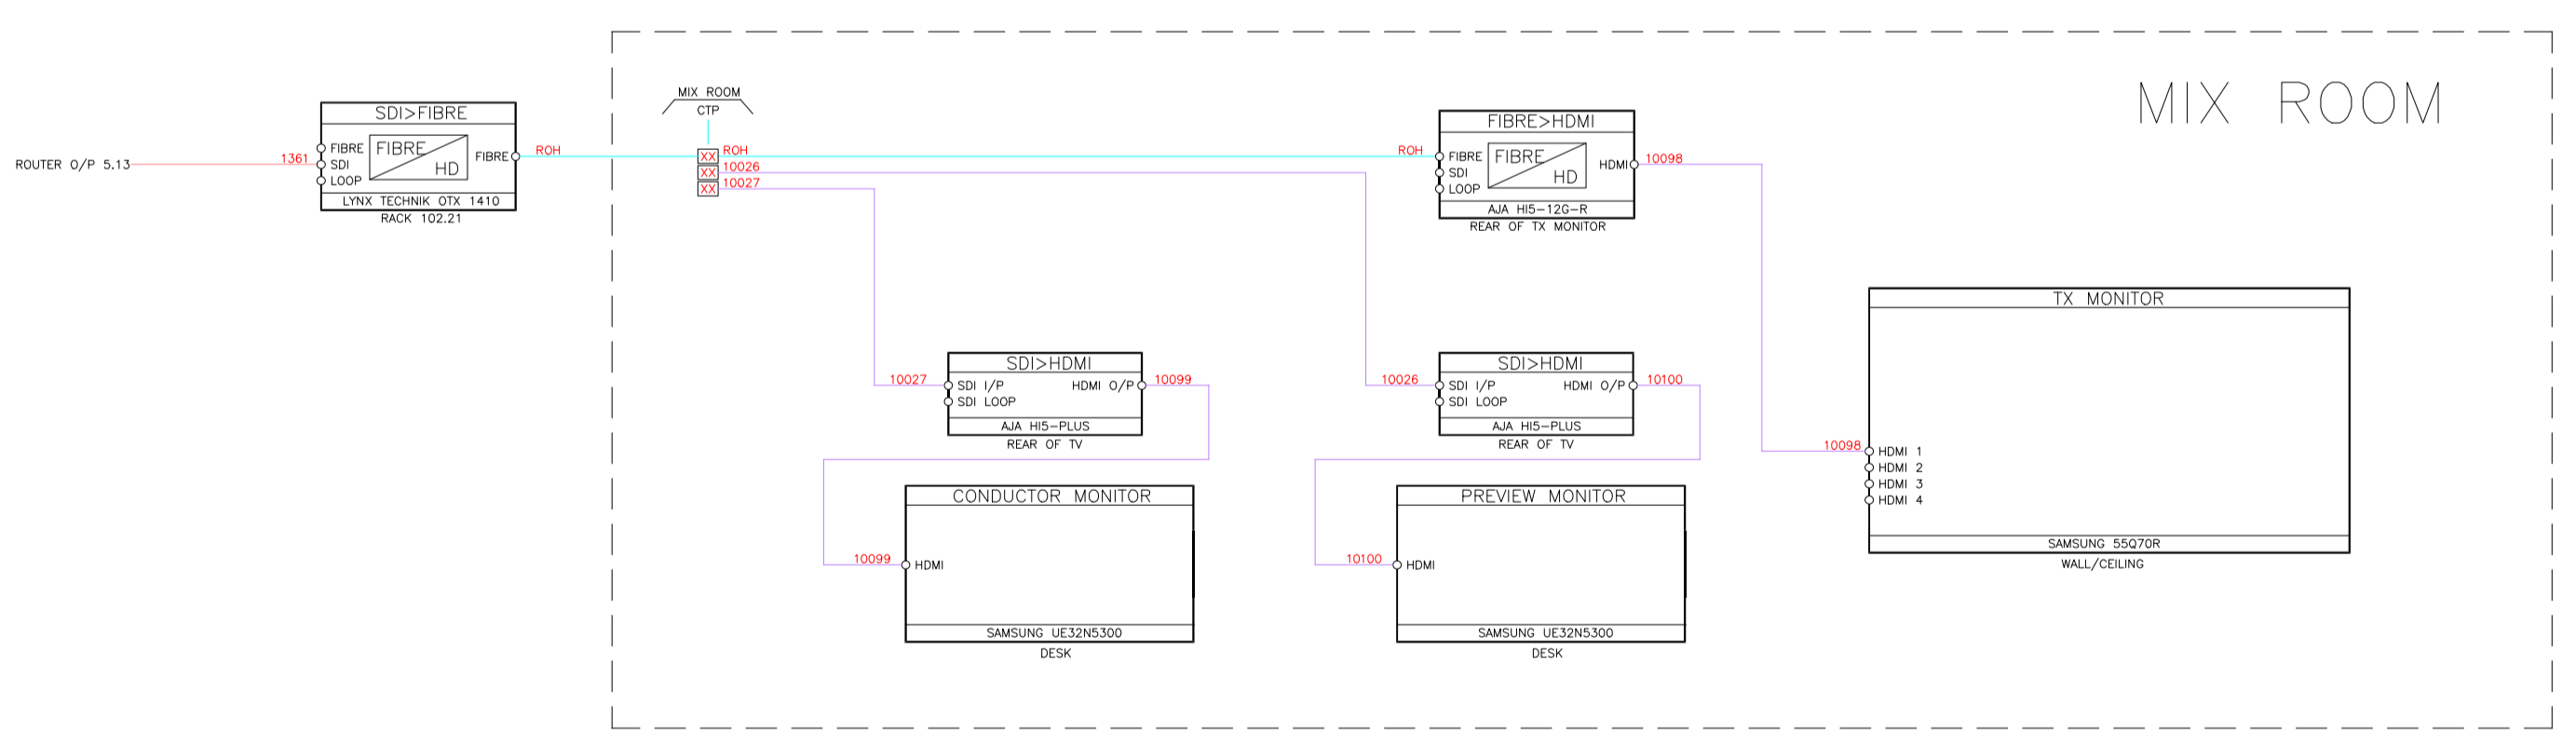


Rev	Description	Revised By	Date	Approved
ALL A	EXTRACTED FROM C45761 ISSUED FOR CLIENT APPROVAL	MFR	27/06/19	
ALL B	MINOR UPDATES ISSUED FOR CLIENT APPROVAL	MFR	26/07/19	
ALL C	AS BUILT	MFR	14/10/19	

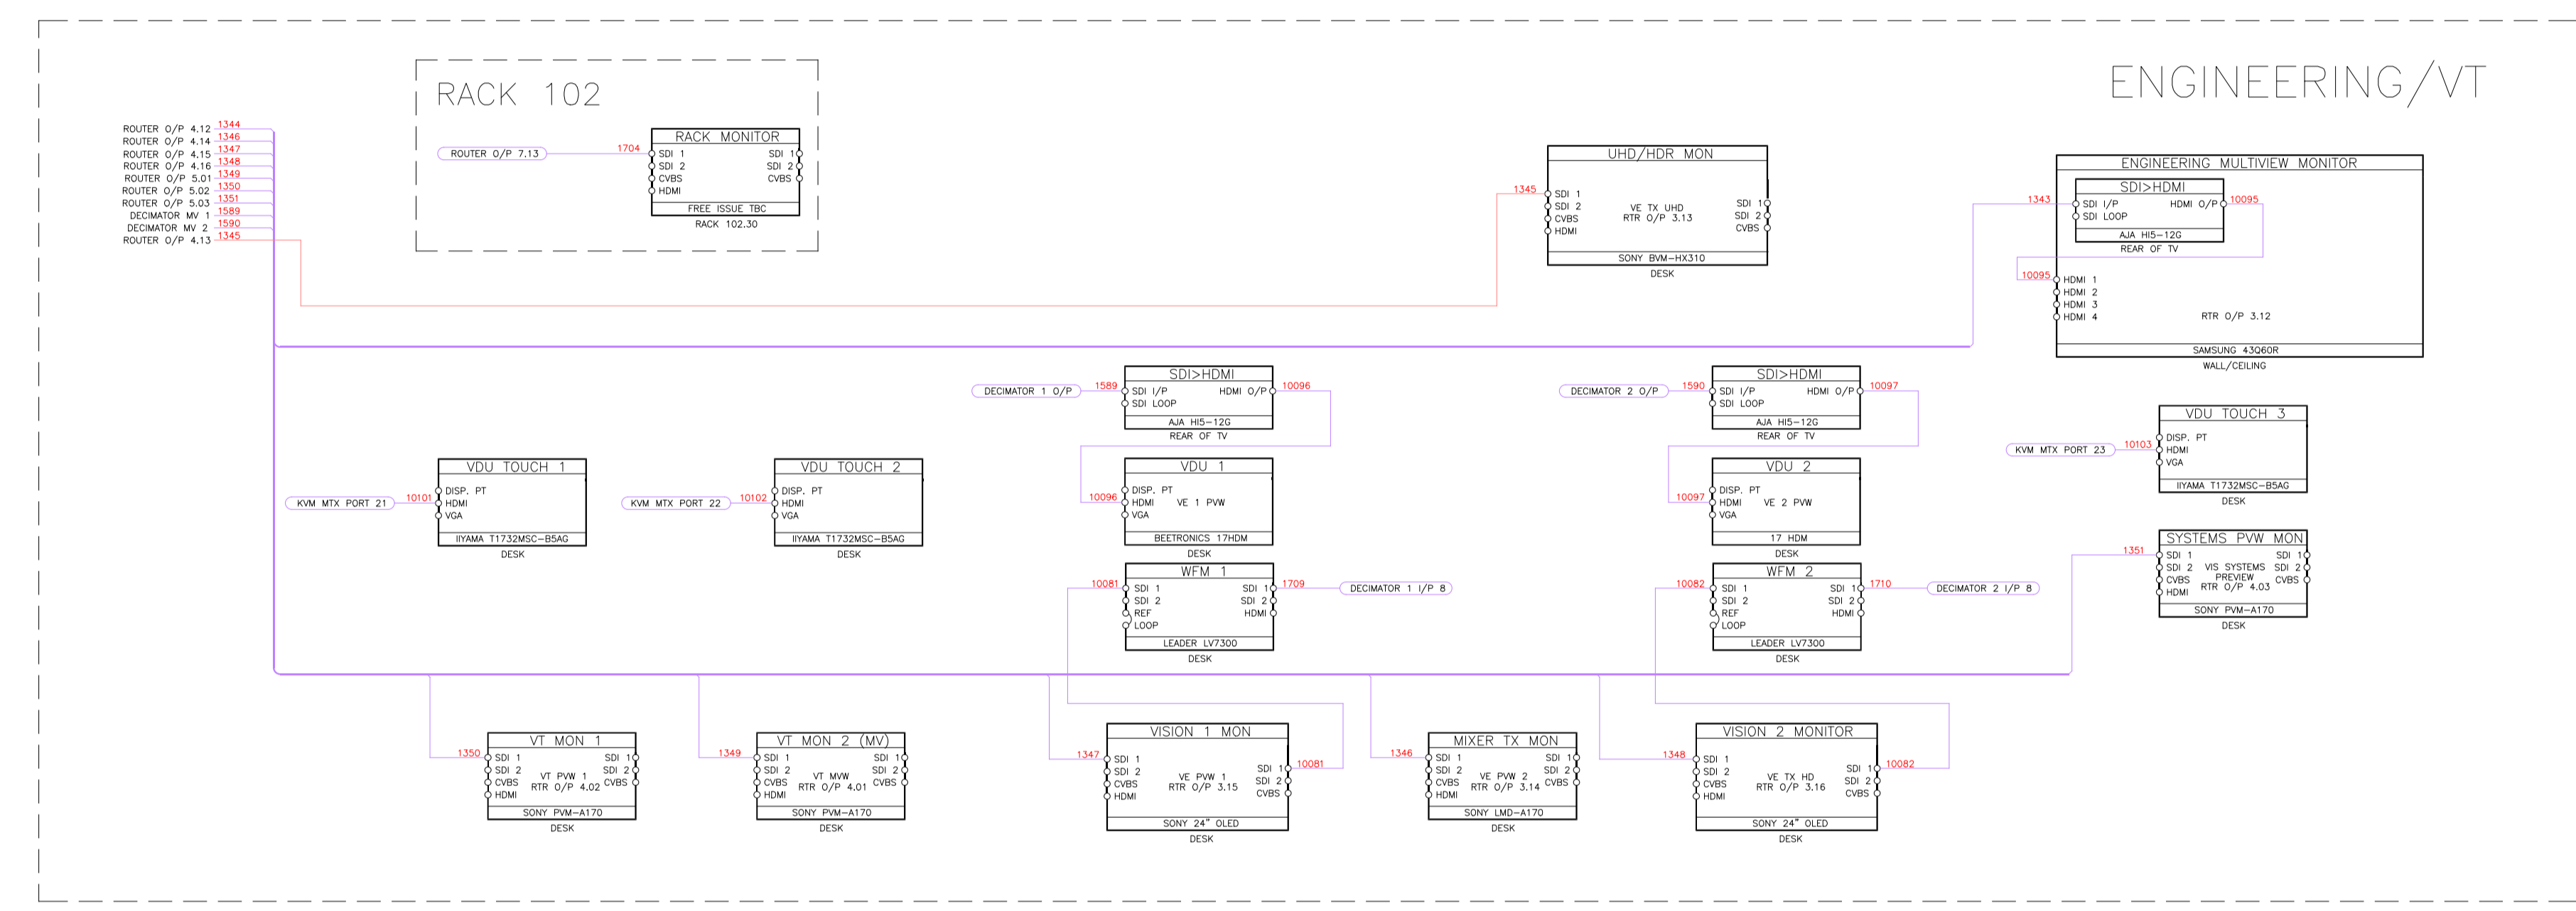

UNIT 39 LANCASTER WAY  
BUSINESS PARK  
WITCHFORD, ELY  
CAMBRIDGESHIRE  
CB6 3NW  
UNITED KINGDOM  
(TEL) +44 (0)1353 645000  
(FAX) +44 (0)1353 658919  
www.megahertz.co.uk

© 2019 MEGHERTZ LIMITED  
The contents of this document are confidential and are not to be disclosed to a third party without the prior written permission of MEGHERTZ LTD.

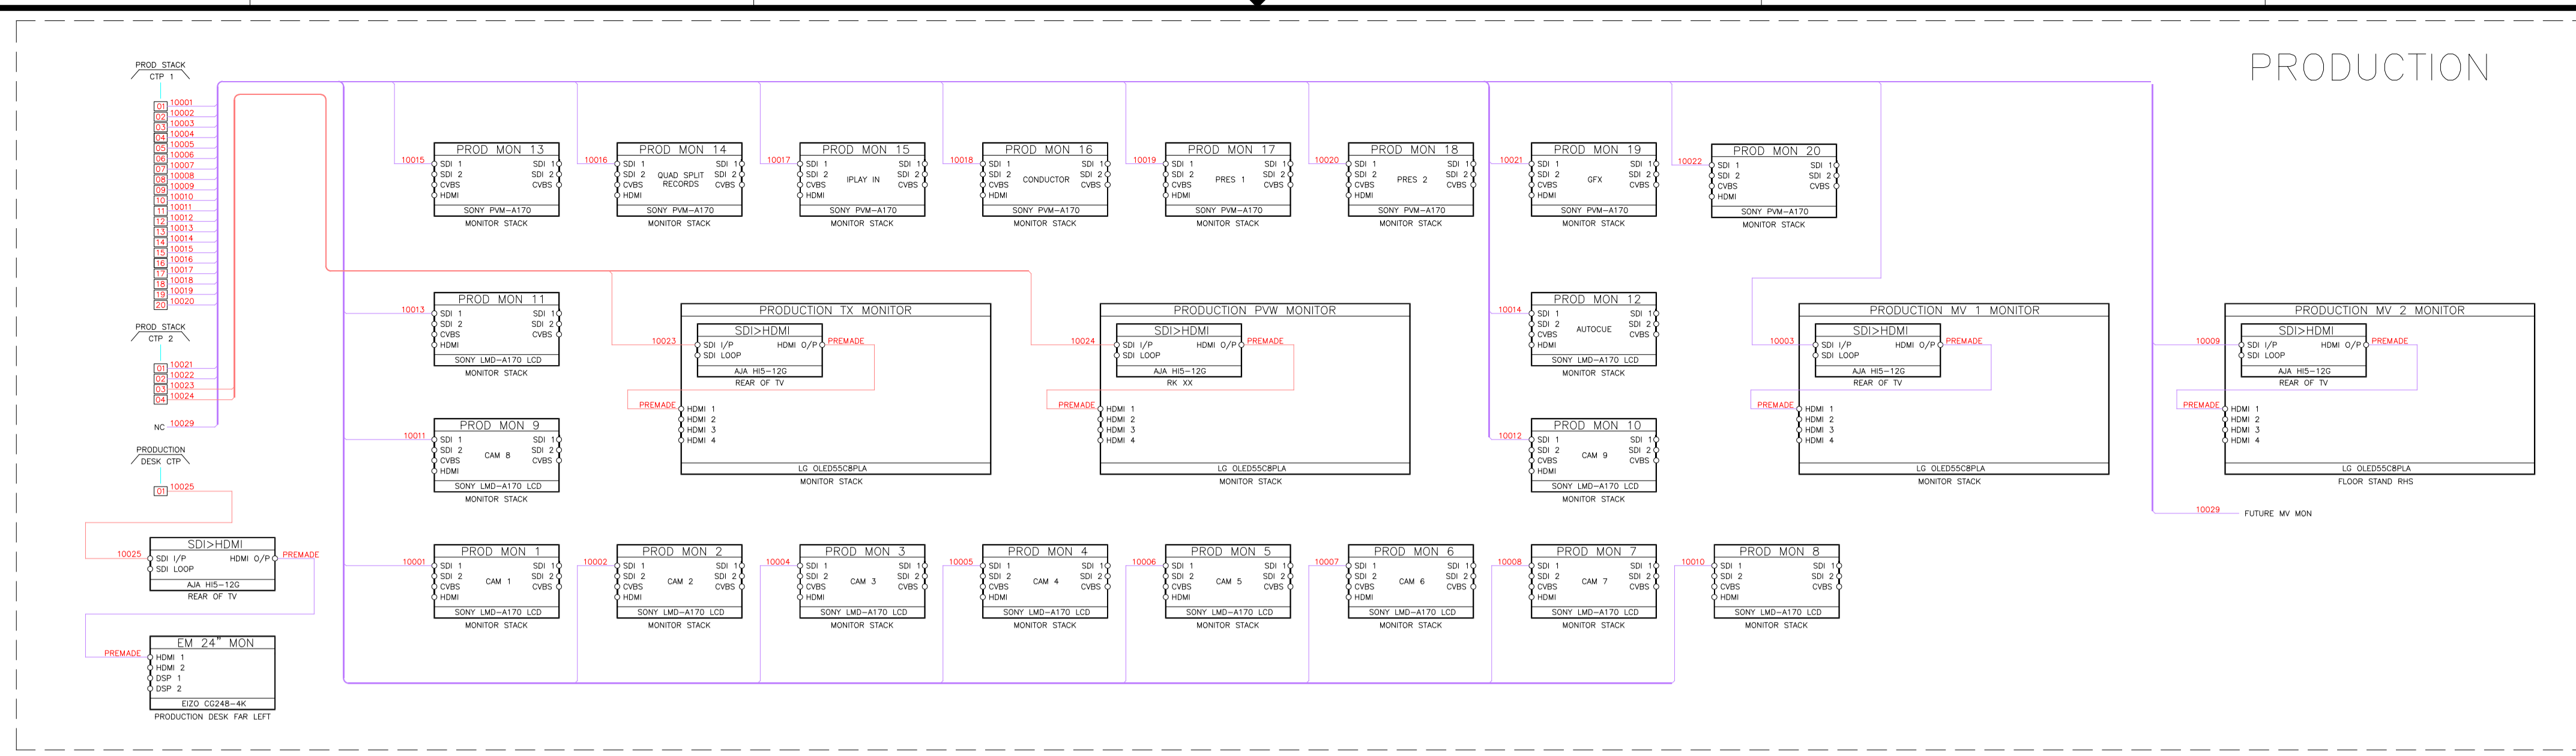

Proj. Mgr.:	VN	Proj. Start Date:	19/05/19
Designer:	PB/MFR	Lead Plot:	
Approved:		Approved Date:	
Drawn:	PB/MFR	Issue Date:	
Scale:	N.T.S.	Last Rev. by:	MFR
The Ref.:	ROH-01-001-001-001-001-001	No. of sheets:	1 of 1

ROYAL OPERA HOUSE  
MEDIA SUITE  
VIDEO MONITORING SCHEMATIC  
Rev: A1 | P/B No: 4537 | Rev: E4537V02 | C