



Rev	Description	Revised By	Date	Approved
ALL	INITIAL DESIGN NOT RELEASED	MPS	18/06/19	
ALL	WORKS UPDATES ISSUED FOR CLIENT APPROVAL	MPS	27/06/19	
ALL	WORKS UPDATES ISSUED FOR APPROVAL	MPS	25/07/19	
ALL	ROUTED BY OUTPUT CONNECTIONS	MPS	25/07/19	
ALL	ASSED OPTICAL FIBRE SIGNAL CABLES	MPS	24/08/19	
ALL	AS BUILT REROUTED WITH 8 SHAD 132 CONNECTIONS	MPS	14/09/19	

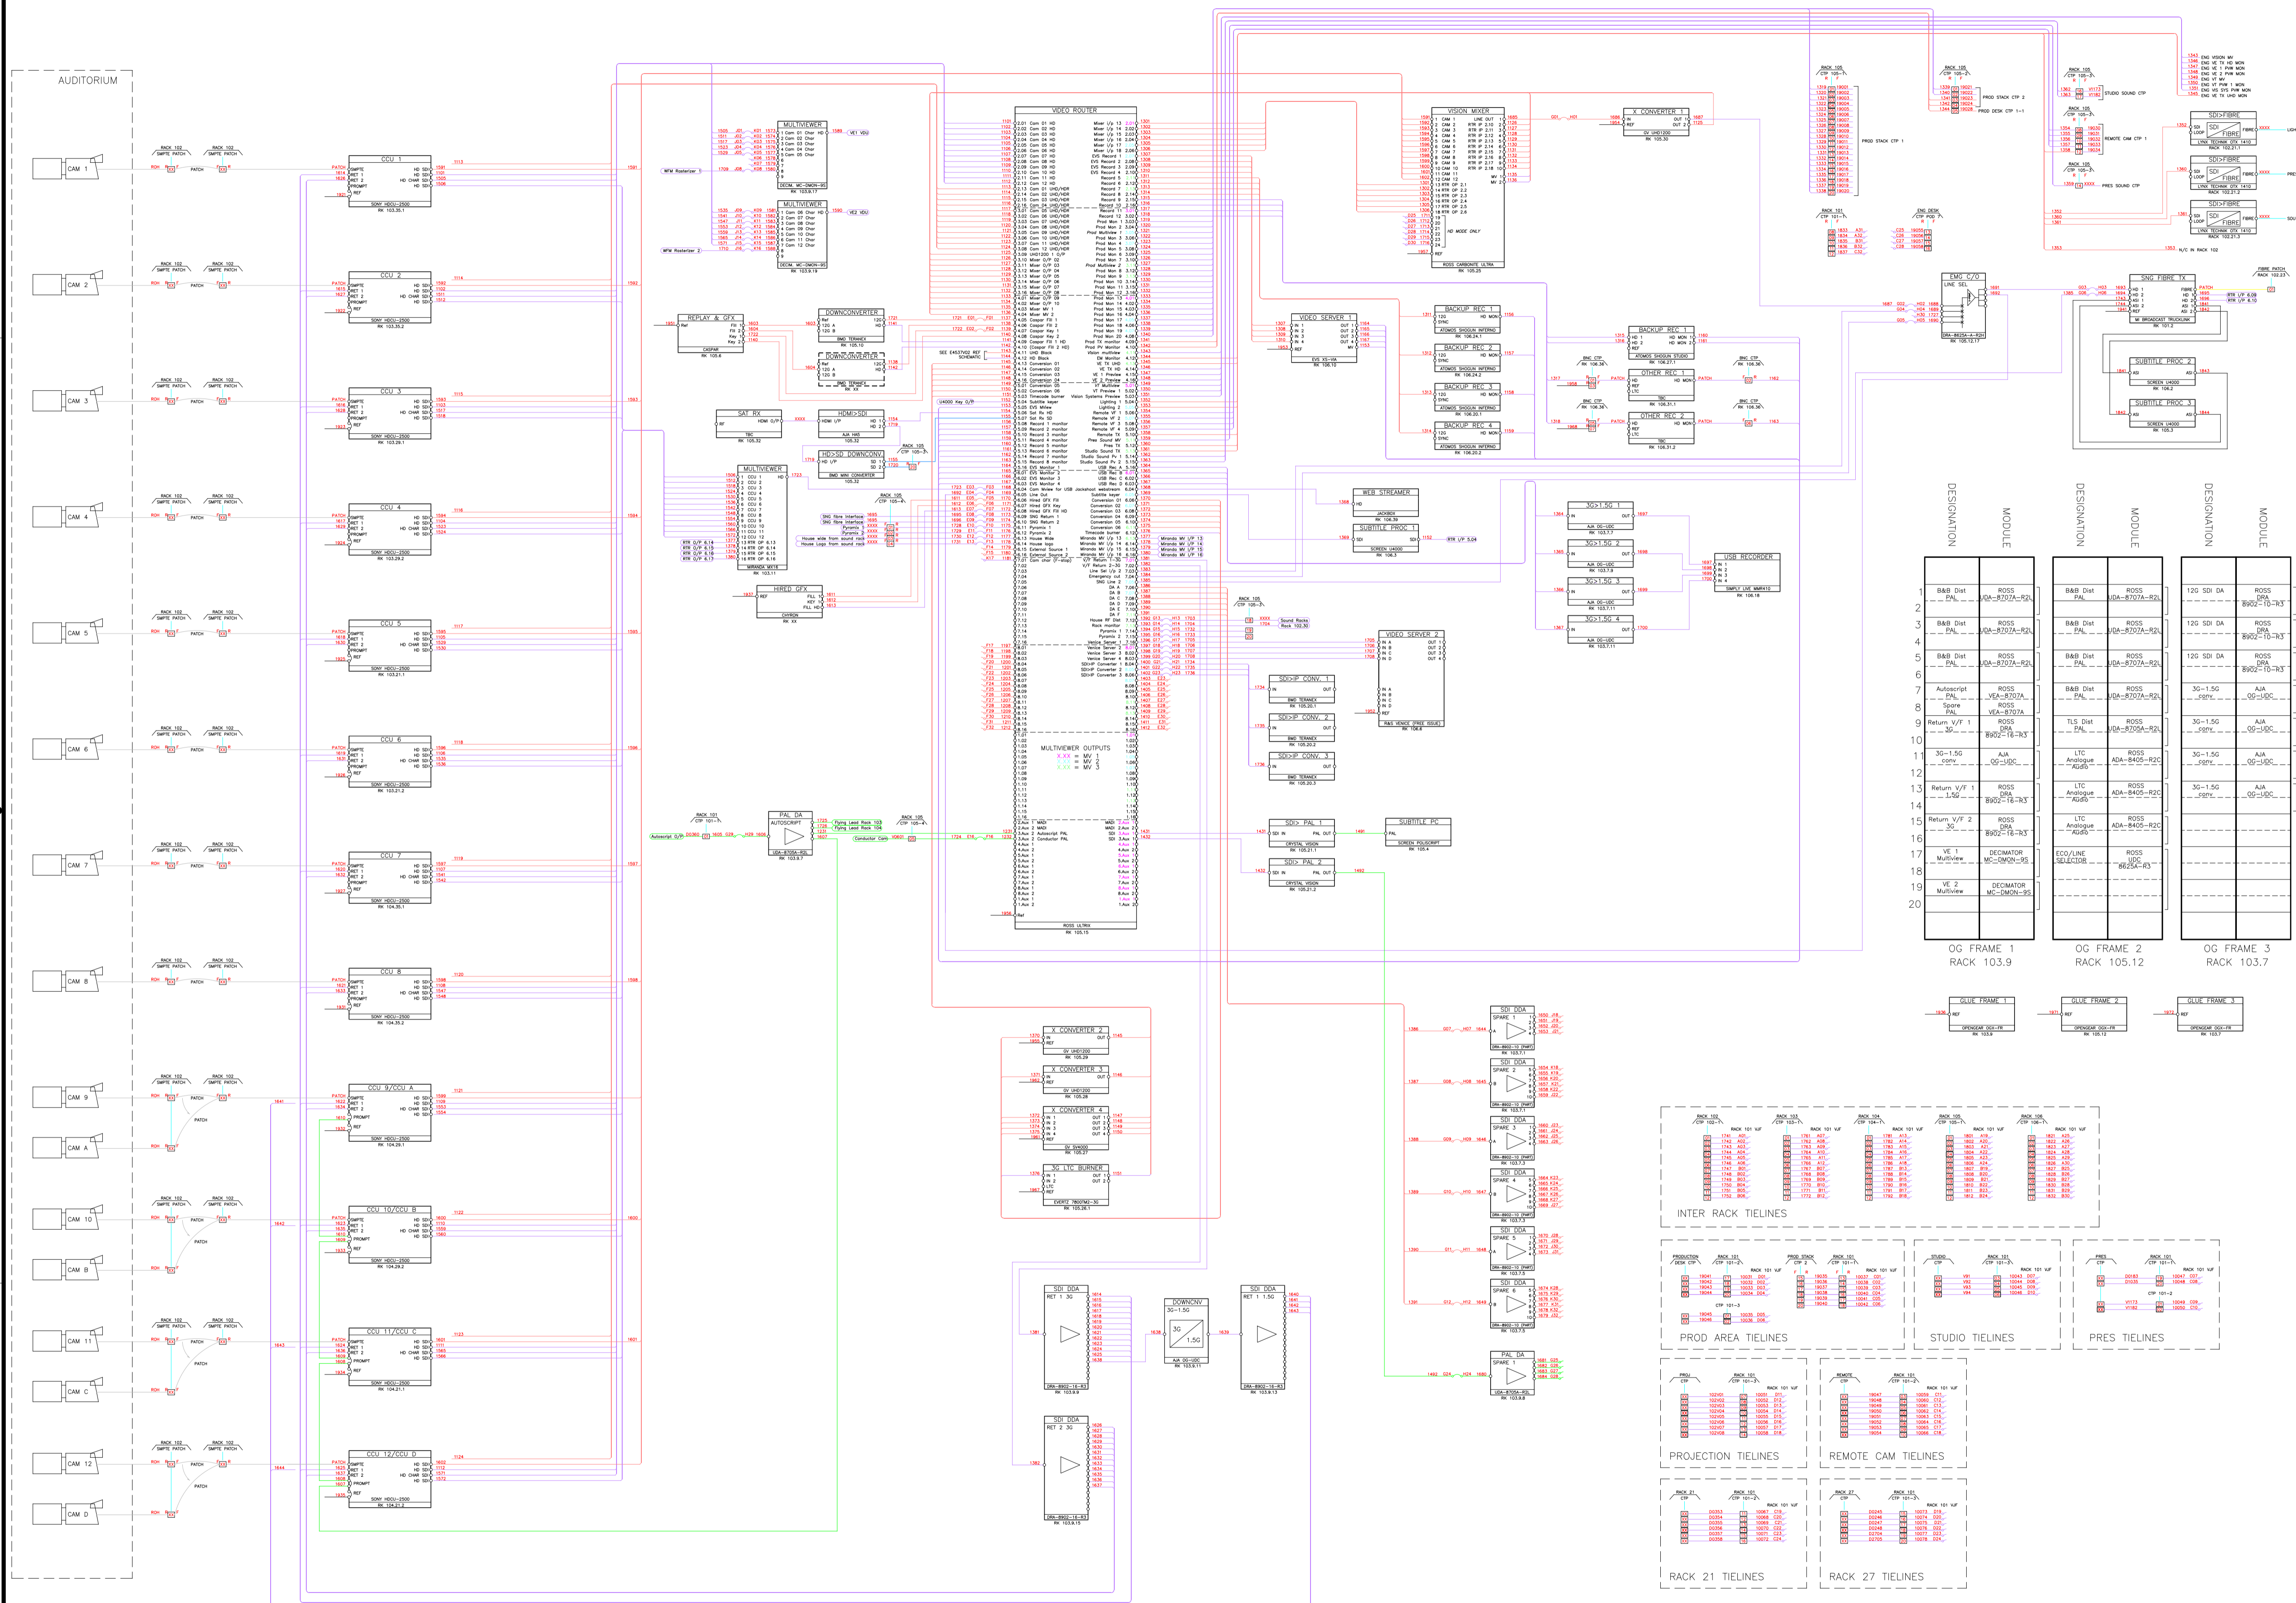

DESIGNATION	MODULE	DESIGNATION	MODULE	DESIGNATION	MODULE
1 BAB Dist PAL	ROSS DA-B207A-R2L	BAB Dist PAL	ROSS DA-B207A-R2L	12G SDI DA	ROSS B802-16-TR3
2 BAB Dist PAL	ROSS DA-B207A-R2L	BAB Dist PAL	ROSS DA-B207A-R2L	12G SDI DA	ROSS B802-16-TR3
3 BAB Dist PAL	ROSS DA-B207A-R2L	BAB Dist PAL	ROSS DA-B207A-R2L	12G SDI DA	ROSS B802-16-TR3
4 BAB Dist PAL	ROSS DA-B207A-R2L	BAB Dist PAL	ROSS DA-B207A-R2L	12G SDI DA	ROSS B802-16-TR3
5 BAB Dist PAL	ROSS DA-B207A-R2L	BAB Dist PAL	ROSS DA-B207A-R2L	12G SDI DA	ROSS B802-16-TR3
6 Autoclip PAL	ROSS VEA-8707A	BAB Dist PAL	ROSS DA-B207A-R2L	3G-1.5G	AJA OG-15C
7 Score PAL	ROSS VEA-8707A	BAB Dist PAL	ROSS DA-B207A-R2L	3G-1.5G	AJA OG-15C
8 Return V/F 1	ROSS DA	TLS Dist PAL	ROSS DA-B207A-R2L	3G-1.5G	AJA OG-15C
9 3G-1.5G	AJA OG-15C	LTC Analogue Input	ADA-B405-R2C	3G-1.5G	AJA OG-15C
10 3G-1.5G	AJA OG-15C	LTC Analogue Input	ADA-B405-R2C	3G-1.5G	AJA OG-15C
11 Return V/F 1	ROSS DA	LTC Analogue Input	ADA-B405-R2C	3G-1.5G	AJA OG-15C
12 3G-1.5G	AJA OG-15C	LTC Analogue Input	ADA-B405-R2C	3G-1.5G	AJA OG-15C
13 3G-1.5G	AJA OG-15C	LTC Analogue Input	ADA-B405-R2C	3G-1.5G	AJA OG-15C
14 Return V/F 2	ROSS DA	LTC Analogue Input	ADA-B405-R2C	3G-1.5G	AJA OG-15C
15 3G-1.5G	AJA OG-15C	LTC Analogue Input	ADA-B405-R2C	3G-1.5G	AJA OG-15C
16 VE 1 Multiviewer	DECIMATOR MC-DM0N-RS	ECO/LINE	ROSS B802-16-TR3	3G-1.5G	AJA OG-15C
17 VE 2 Multiviewer	DECIMATOR MC-DM0N-RS	ECO/LINE	ROSS B802-16-TR3	3G-1.5G	AJA OG-15C
18					
19					
20					

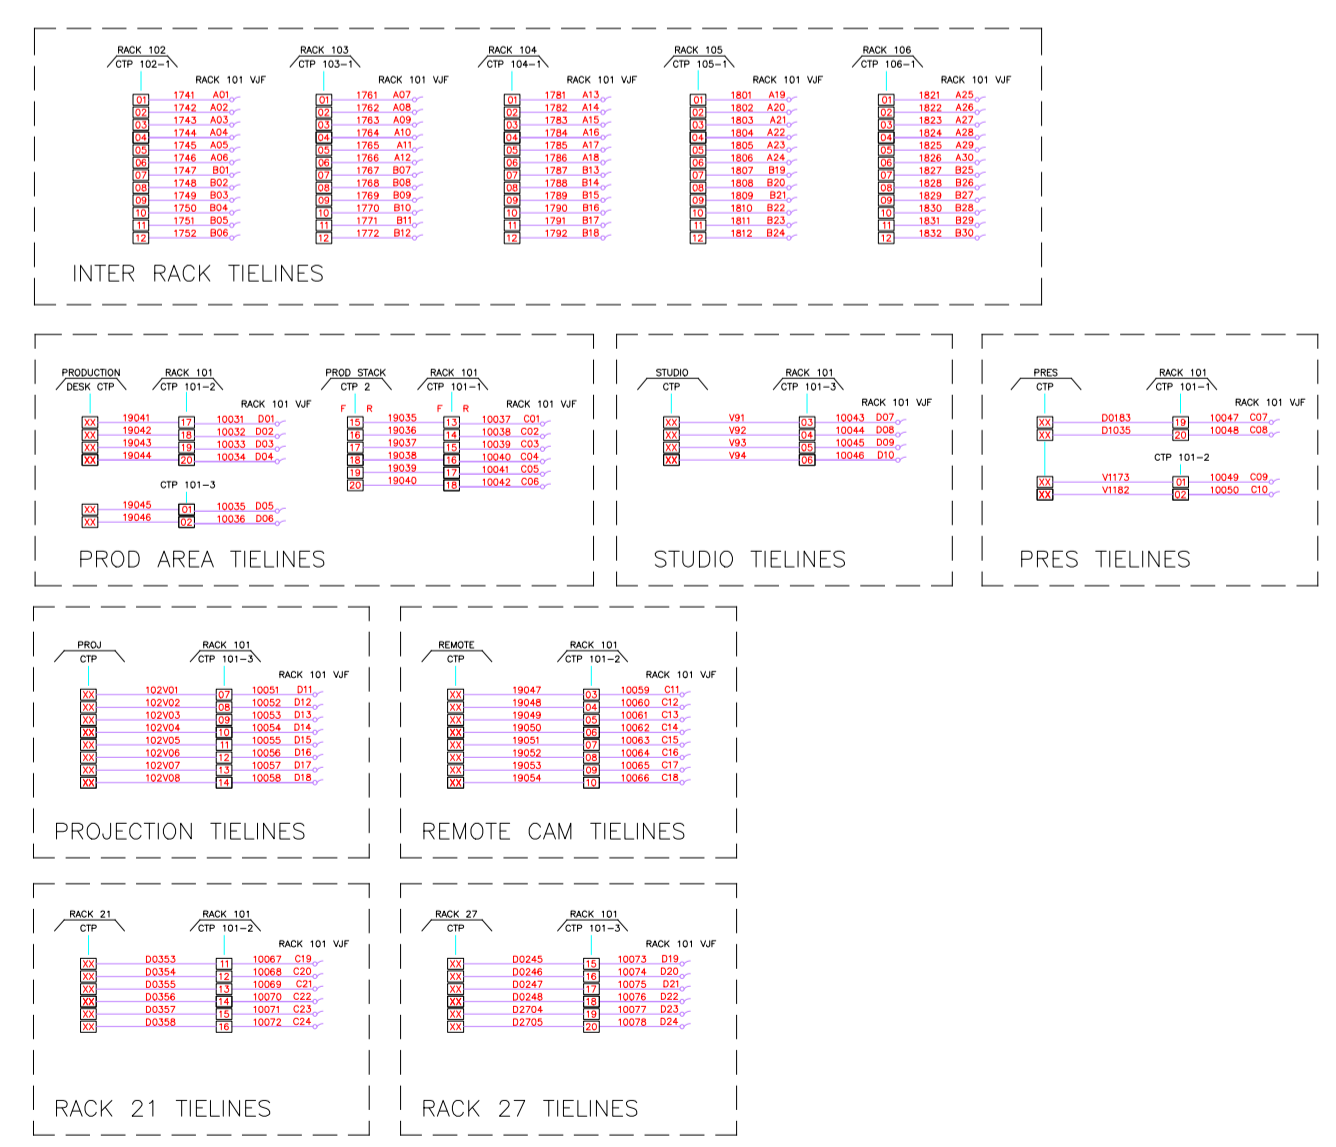

MHZ

UNIT 39 LANCASTER WAY
 BUSINESS PARK
 WITCHFORD, ELY
 CAMBRIDGESHIRE
 CB6 3NW
 UNITED KINGDOM
 (TEL) +44 (0)1353 645000
 (FAX) +44 (0)1353 658919
 www.meghertz.co.uk

© 2019 MEGHERTZ LIMITED
 The contents of this document are confidential and are not to be disclosed to a third party without the prior written permission of MEGHERTZ LTD.

ROYAL OPERA HOUSE
 COVENT GARDEN

Proj. No.:	VN	Proj. Start Date:	19/05/19
Designer:	PB/MPR	Lead Plot:	
Approved:		Approval Date:	
Drawn:	PB/MPR	Issue Date:	
Scale:	N.T.S.	Last Rev. by:	MPS
The Ref.:	ROYAL OPERA HOUSE VIDEO SCHEMATIC	No. of sheets:	1 of 1

ROYAL OPERA HOUSE
 ROH
 MEDIA SUITE
 VIDEO SCHEMATIC

Rev: A1 | No: 4537 | Rev: E4537V01 | D